

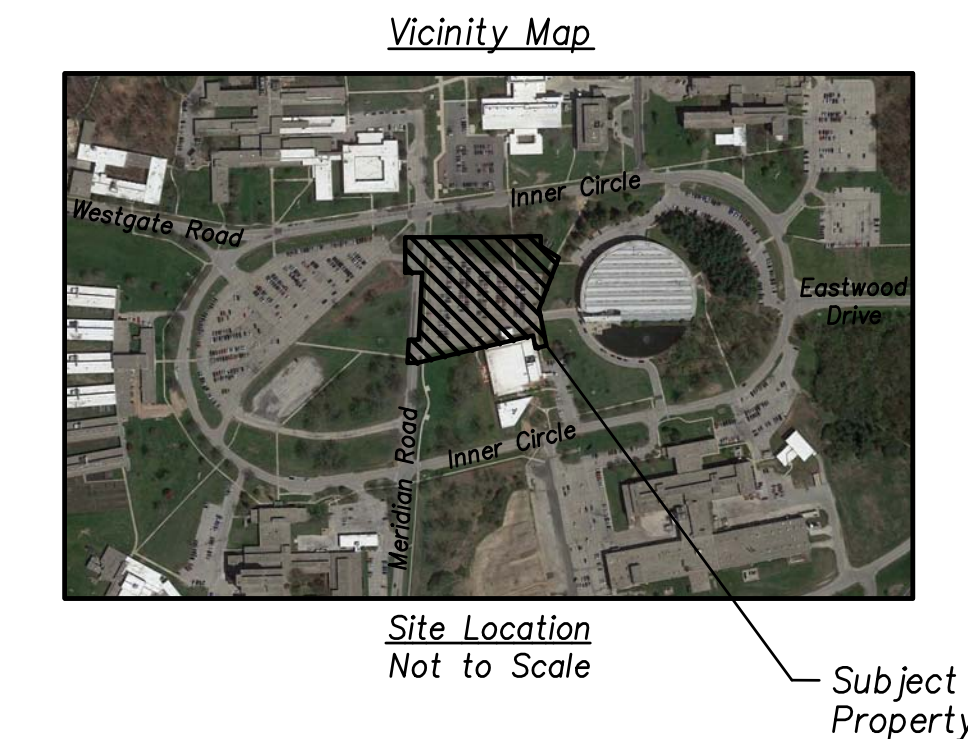


PLAT OF TOPOGRAPHY

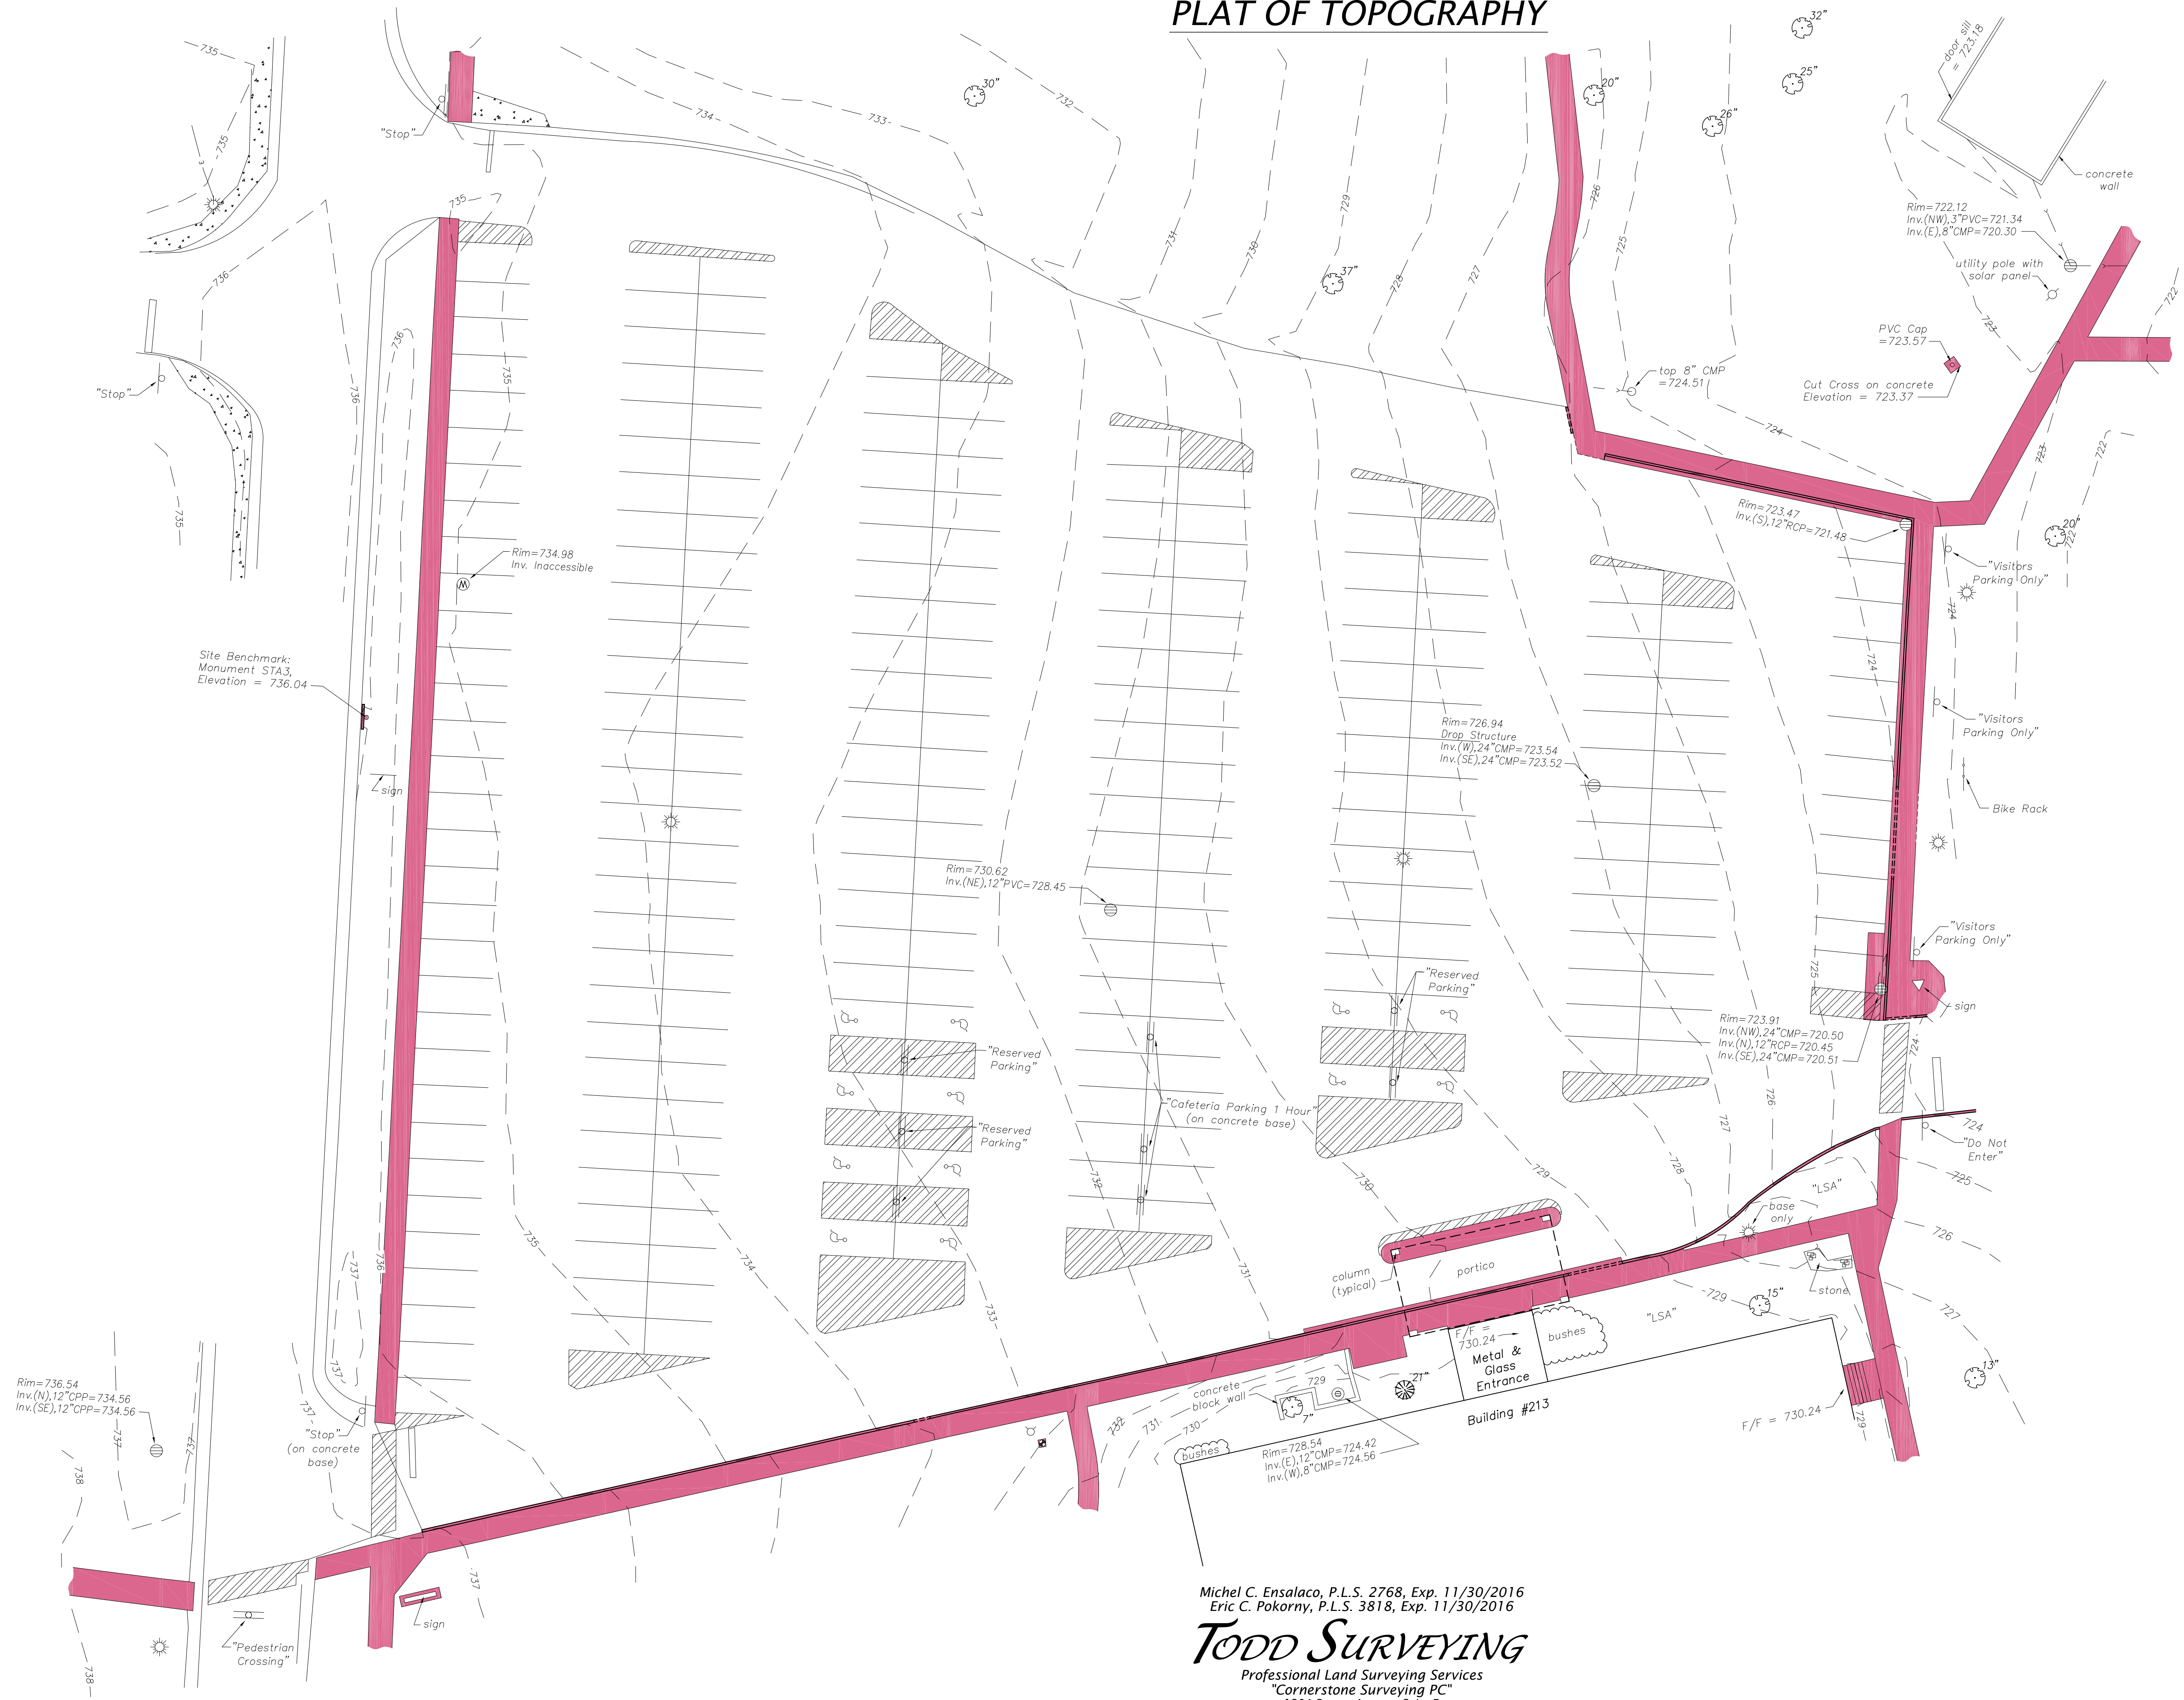

Notes:
Source & Site Benchmark:
Argonne National Laboratory Survey Monument STA3,
Elevation = 736.04 (NAD83)
Underground utility routings protracted herein are based upon field location of flags and/or paint marks by others.
Graphic depiction of some symbol locations and utility lines have been exaggerated for visual clarity.

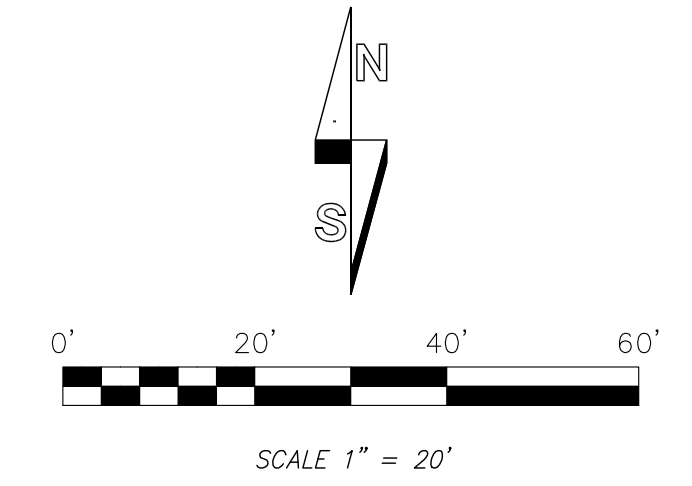

- Legend
- 13" = coniferous tree and tree size
 - 10" = deciduous tree and tree size
 - = sign
 - = double signs
 - = handicapped parking
 - = light pole
 - = inlet
 - = beehive inlet
 - = manhole
 - = fire hydrant
 - = water valve
 - = utility pole
 - "LSA" = landscaped area
 - = storm line
 - = concrete curb
 - = depressed curb
 - = contour line
 - = gravel
 - = concrete
 - = asphalt

PREPARED ON JULY 28, 2015 BY:
ERIC C. POKORNY
I.P.L.S. NO. 3818

Michel C. Ensalaco, P.L.S. 2768, Exp. 11/30/2016
Eric C. Pokorny, P.L.S. 3818, Exp. 11/30/2016
TODD SURVEYING
Professional Land Surveying Services
"Cornerstone Surveying PC"
1304 Sunset Avenue, Suite E
Yorkville, IL 60560
Phone: 630-892-1309 Fax: 630-892-5544
Survey is only valid if original seal is shown in red.

Client:	Middaugh, Inc.
Book & Sheet:	2303/Sheet
Drawn By:	ME/EP
Plot #/N/A	
Reference:	
Field Work Completed:	07/22/2015
Rev. Date/Rev. Description	
Project Number:	2015-1128 TOPO